

SOUND CONCEPTS LLC
 1233 Castle Dr. Ste A5 Mason, Oh 45040
 513-703-0147
 customerservice@soundconceptsllc.com
 www.soundconceptsllc.com


Wire Color Legend

Black	AC	AC Line
Blue	B	Audio, Balanced
Purple	U	Audio, Unbalanced
Brown	S	Speaker
Teal	DA	Digital Audio
Yellow	E	Data
Green		Ground Circuit
Light Blue	BL	BLU Link
Pink	C	Co-Ax
Red	DC	DC Power
Light Green	CO	Serial
Light Yellow	DM	Digital Media 8G
Orange	F	Fiber
Pink	H	HDMI - DVI
Grey	A	As Marked

Preliminary

Proprietary & Confidential
 Property of Sound Concepts LLC
 Copyright 2019

CUSTOMER	
Anderson Hills	
Address	
PROJECT	
Connections Center	
Proj #	Dwg #
50266	50794
Date	Revision
6-26-2019	2
DRAWN BY	PAGE
J Murphy	1 OF 1

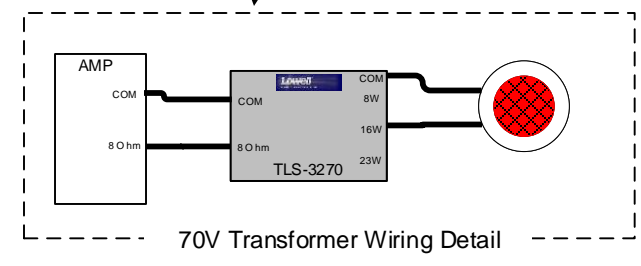

From Fellowship Hall Crestron DM8x8

