




SOUND CONCEPTS LLC

1233 Castle Dr. Ste A5 Mason, Oh 45040
513-703-0147

customerservice@soundconceptsllc.com
www.soundconceptsllc.com

Wire Color Legend

- AC AC Line
- B Audio, Balanced
- U Audio, Unbalanced
- S Speaker
- DA Digital Audio
- E CAT Cable
- DS CAT Shielded
- G Ground Circuit
- BL BLU Link
- C Co-Ax
- DC DC Power
- CO Serial
- U USB
- F Fiber
- H SDI - HDMI - DVI
- HD As Marked
- A As Marked

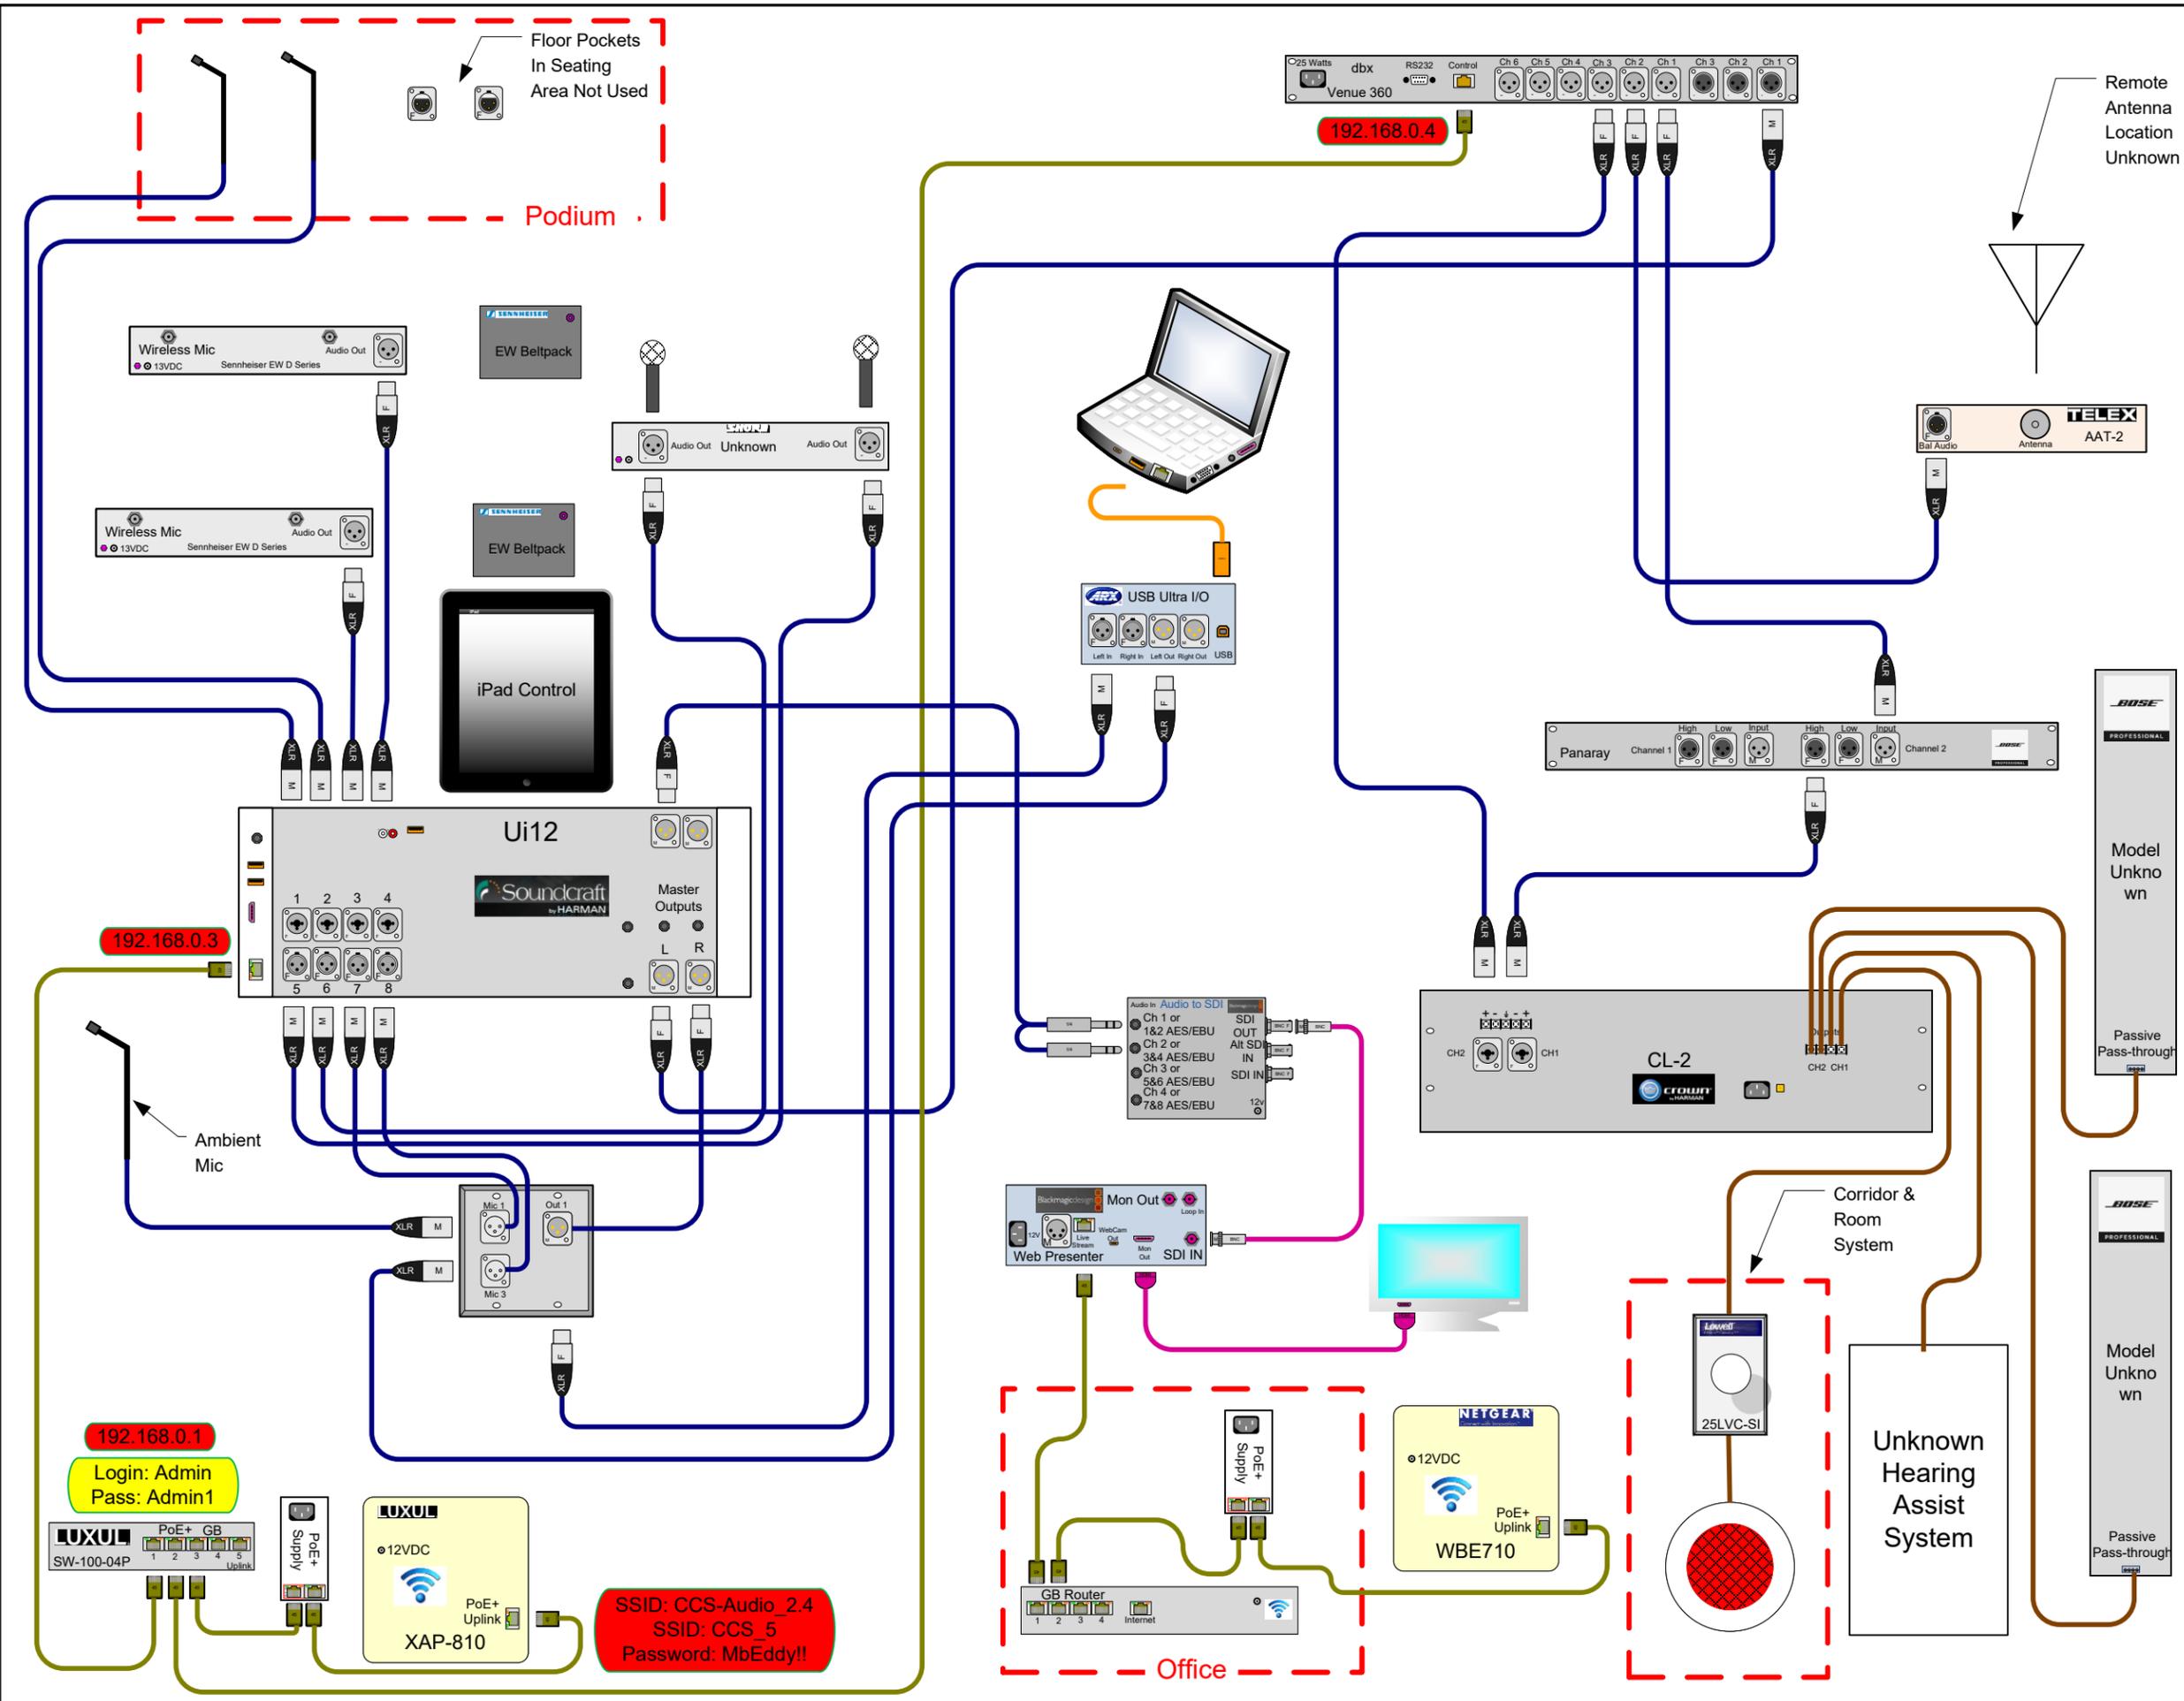

Proprietary & Confidential
Property of Sound Concepts LLC
Copyright 2026

As Built

CUSTOMER	
First Church of Christ Scientist	
Address	
3035 Erie Ave Cincinnati OH 45208	
PROJECT	
Audio/Streaming Systems	
Proj #	Dwg #
Date	Revision
3-10-2026	2
DRAWN BY	PAGE
J Murphy	1 OF 1