




SOUND CONCEPTS LLC
1233 Castle Dr. Ste A5 Mason, Oh 45040
513-703-0147
customerservice@soundconceptsllc.com
www.soundconceptsllc.com

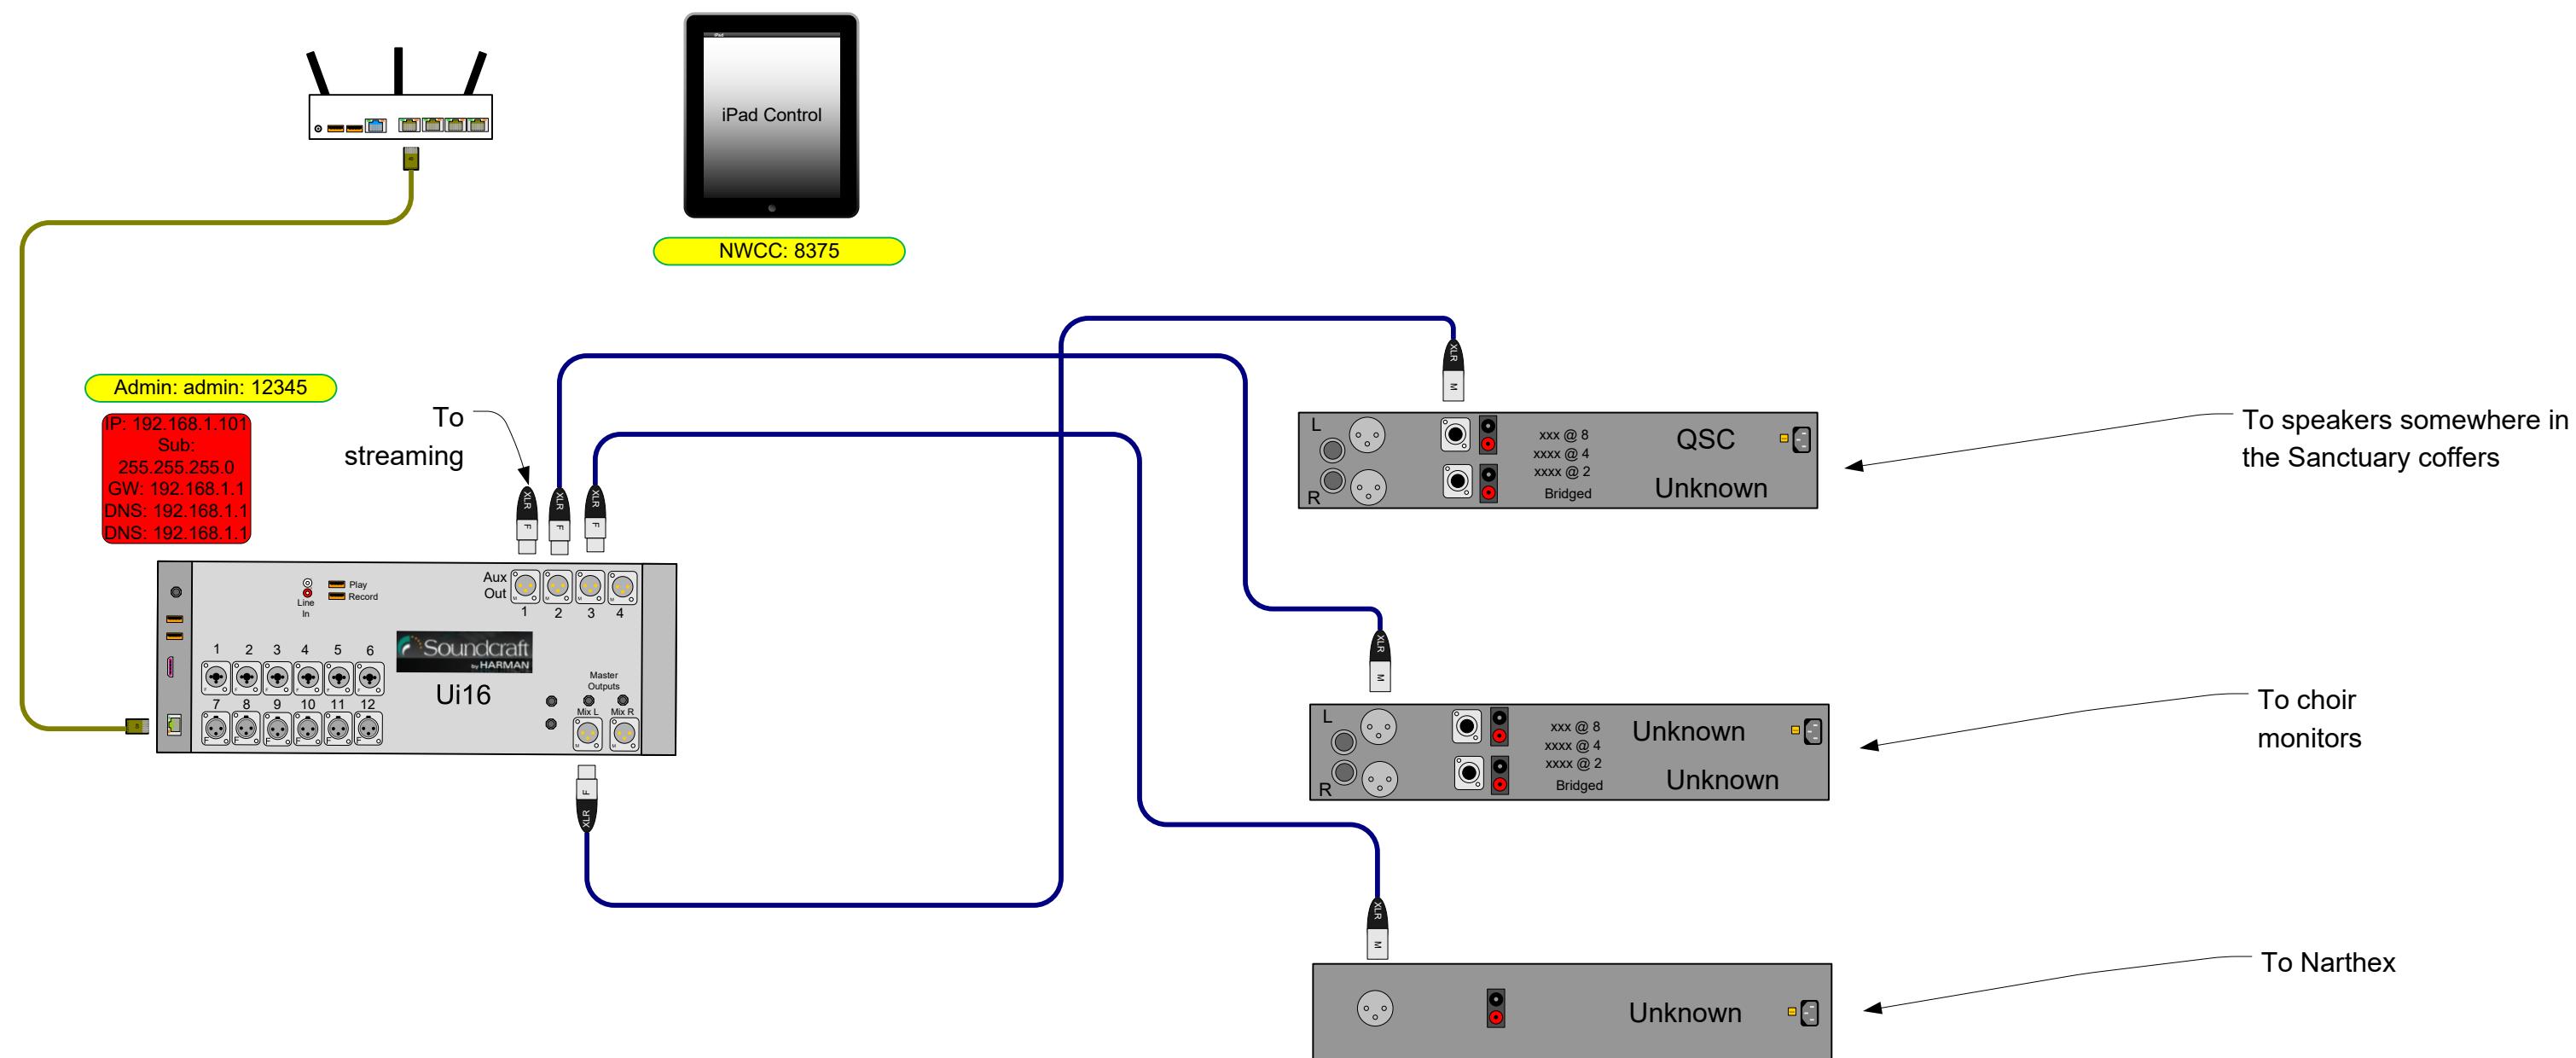

Proprietary & Confidential
Property of Sound Concepts LLC
Copyright 2026

CUSTOMER
Resounding Joy Church
Address

PROJECT
Audio As Built

Proj #	Dwg #
2-5-26	2
DRAWN BY	PAGE
J Murphy	1 OF 1