




## **SOUND CONCEPTS LLC**

1233 Castle Dr. Ste A5 Mason, Oh 45040

513-703-0147

[customerservice@soundconceptsllc.com](mailto:customerservice@soundconceptsllc.com)

[www.soundconceptsllc.com](http://www.soundconceptsllc.com)

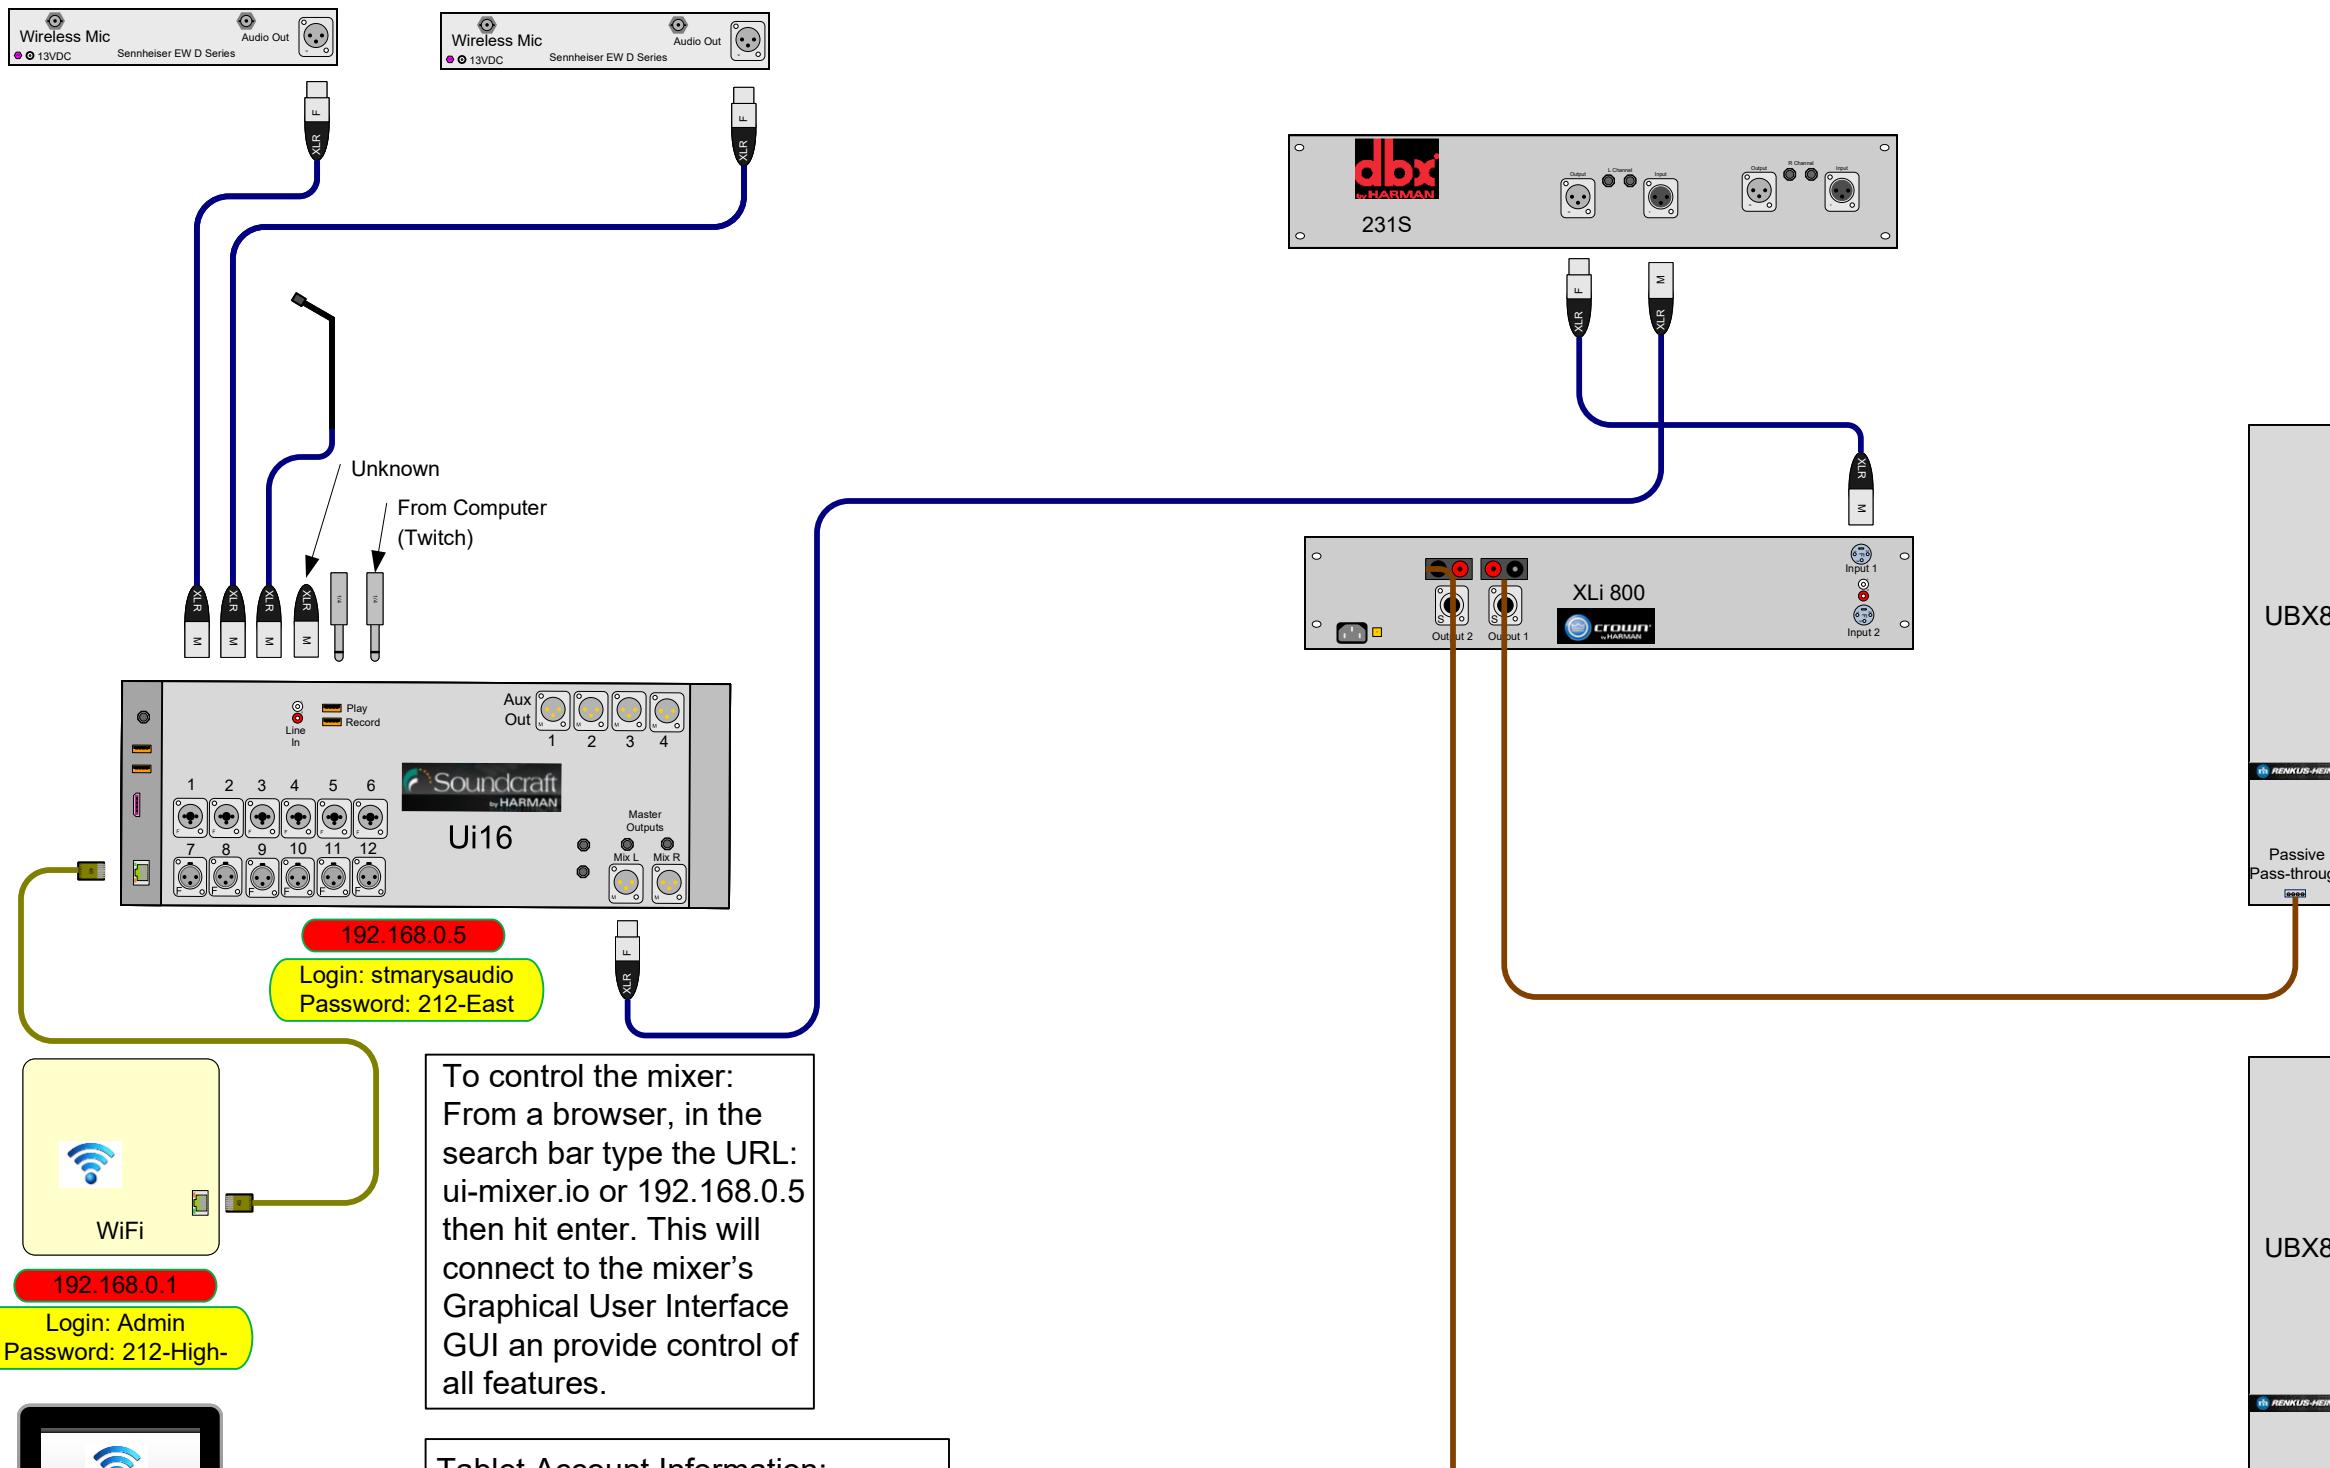

## Wire Color Legend

	<b>AC</b>	<b>AC Line</b>
	<b>B</b>	<b>Audio, Balanced</b>
	<b>U</b>	<b>Audio, Unbalanced</b>
	<b>S</b>	<b>Speaker</b>
	<b>DA</b>	<b>Digital Audio</b>
	<b>E</b>	<b>CAT Cable</b>
	<b>DS</b>	<b>CAT Shielded</b>
		<b>Ground Circuit</b>
	<b>BL</b>	<b>BLU Link</b>
	<b>C</b>	<b>Co-Ax</b>
	<b>DC</b>	<b>DC Power</b>
	<b>CO</b>	<b>Serial</b>
	<b>U</b>	<b>USB</b>
	<b>F</b>	<b>Fiber</b>
	<b>H</b>	<b>SDI - HDMI - DVI</b>
	<b>HD</b>	<b>As Marked</b>
	<b>A</b>	<b>As Marked</b>

Device IP Address 000.000.000.000  
Login Info 000.000.000.000

Proprietary & Confidential  
Property of Sound Concepts LLC  
Copyright 2026

## CUSTOMER

# St Mary's Catholic Church

Hillsboro, OH

## PROJECT

Proj #	Dwg #
--------	-------

Date	Revision
------	----------

1-23-2025	0
DRAWN BY	PAGE

J Murphy